


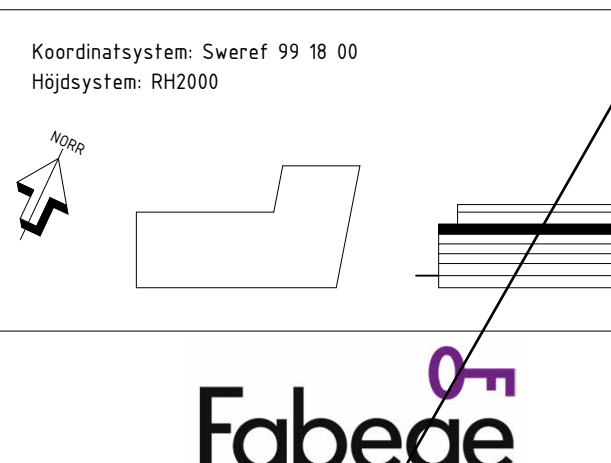

BET	ANDRØINGEN AVYSER	SEEN	DATUM
RELATIONSHANDLING			
Koordinatsystem: Sverref 99 18 00 Højdssystem: RH2000			
			
A	AIX ARKITEKTER AB Adress	TEL: 06-494 29 00	
K	HBILSTATIK AB Adress	TEL: 06-464 90 00	
V	INCORD AB Adress	TEL: 06-422 29 00	
E	Electro Engineering Adress	TEL: 06-488 28 50	
P	Adress	TEL: -	
L	Adress	TEL:000-000000. FAX:000-000000	
OBJEKTSNUMMER		PROJEKTNUMMER	
UPPDRAG NR OK2316-01-01		136 002	
DATUM 2019-04-29		ANSVARIG Tobias Rosberg	
GBK Förstudie Plan, Yläning 5 Copy 2		HANDLÄGGARE DaHa	
SKALA (A1)	NUMMER	BET	
1:100	A-400-1-05003		